


- Scale 1:100.

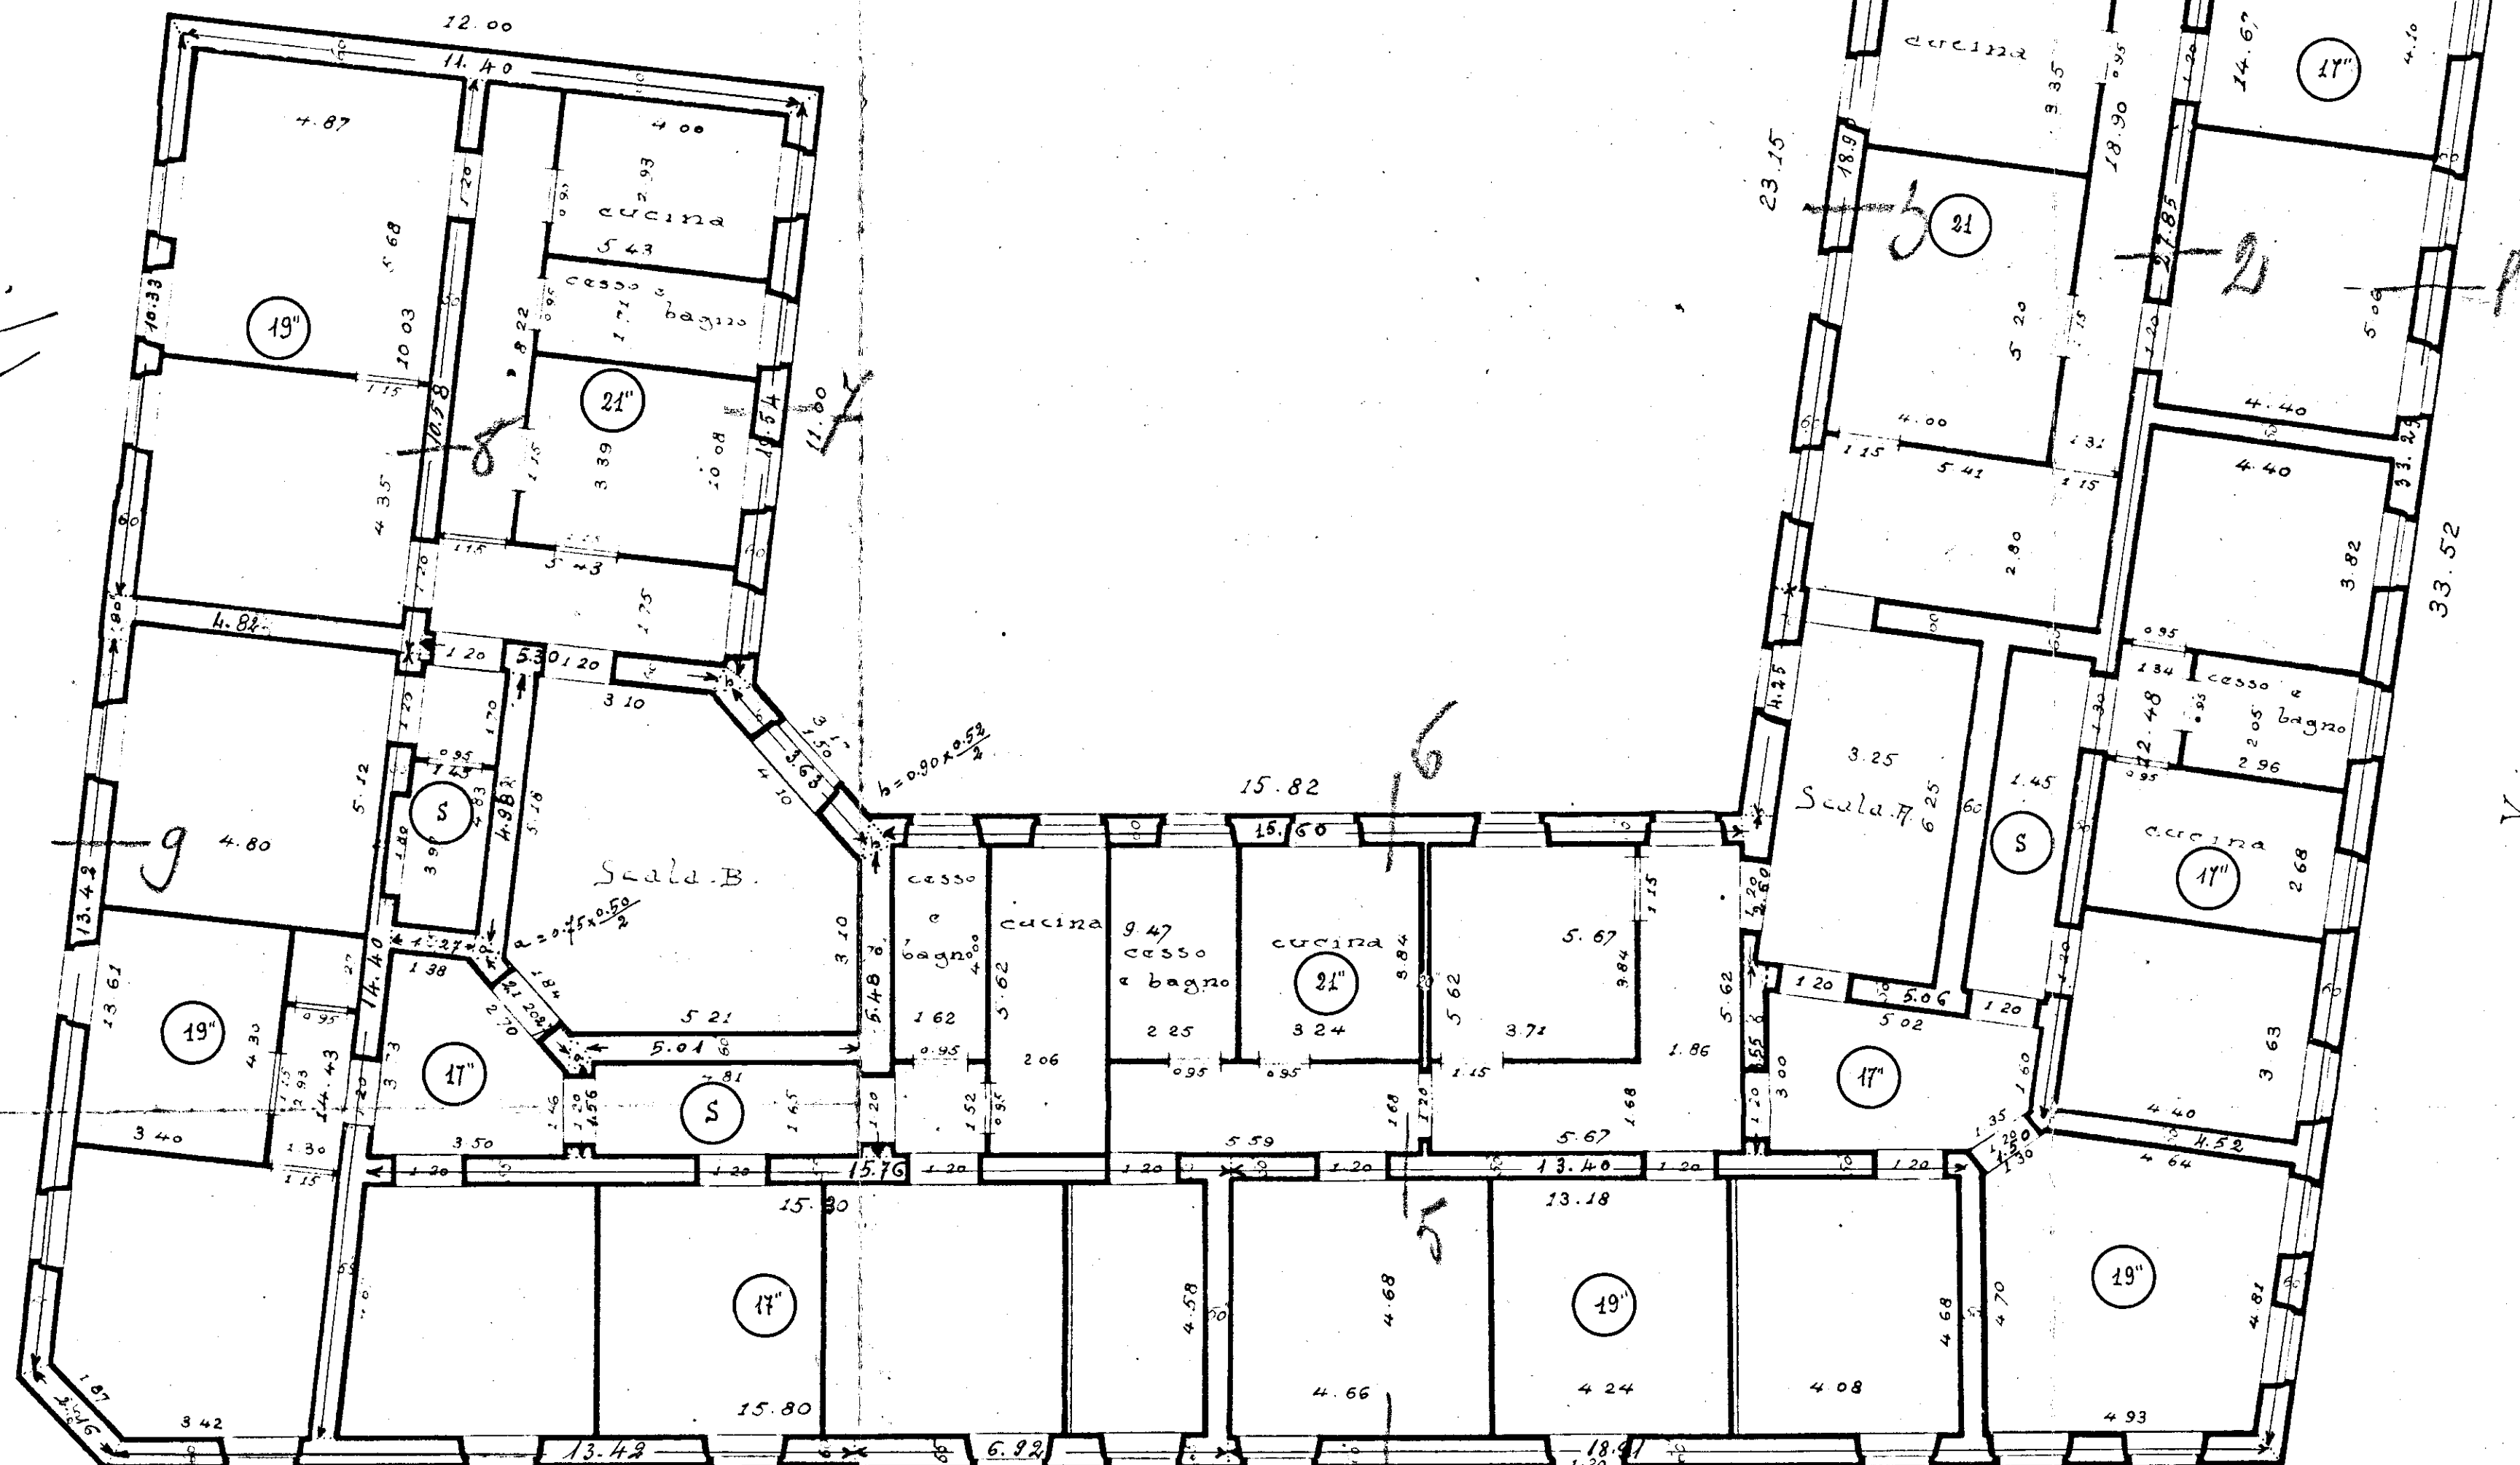

$\textcircled{h}$ solai

Via Indipendenza

fabbricato ferroviari

Viola

Pin Point

~~U. Philaei~~
~~Gr. Laka~~