


OSTUNI - C / 13575

PALAZZINA C - Scale 1:100

## Piante Fondazioni

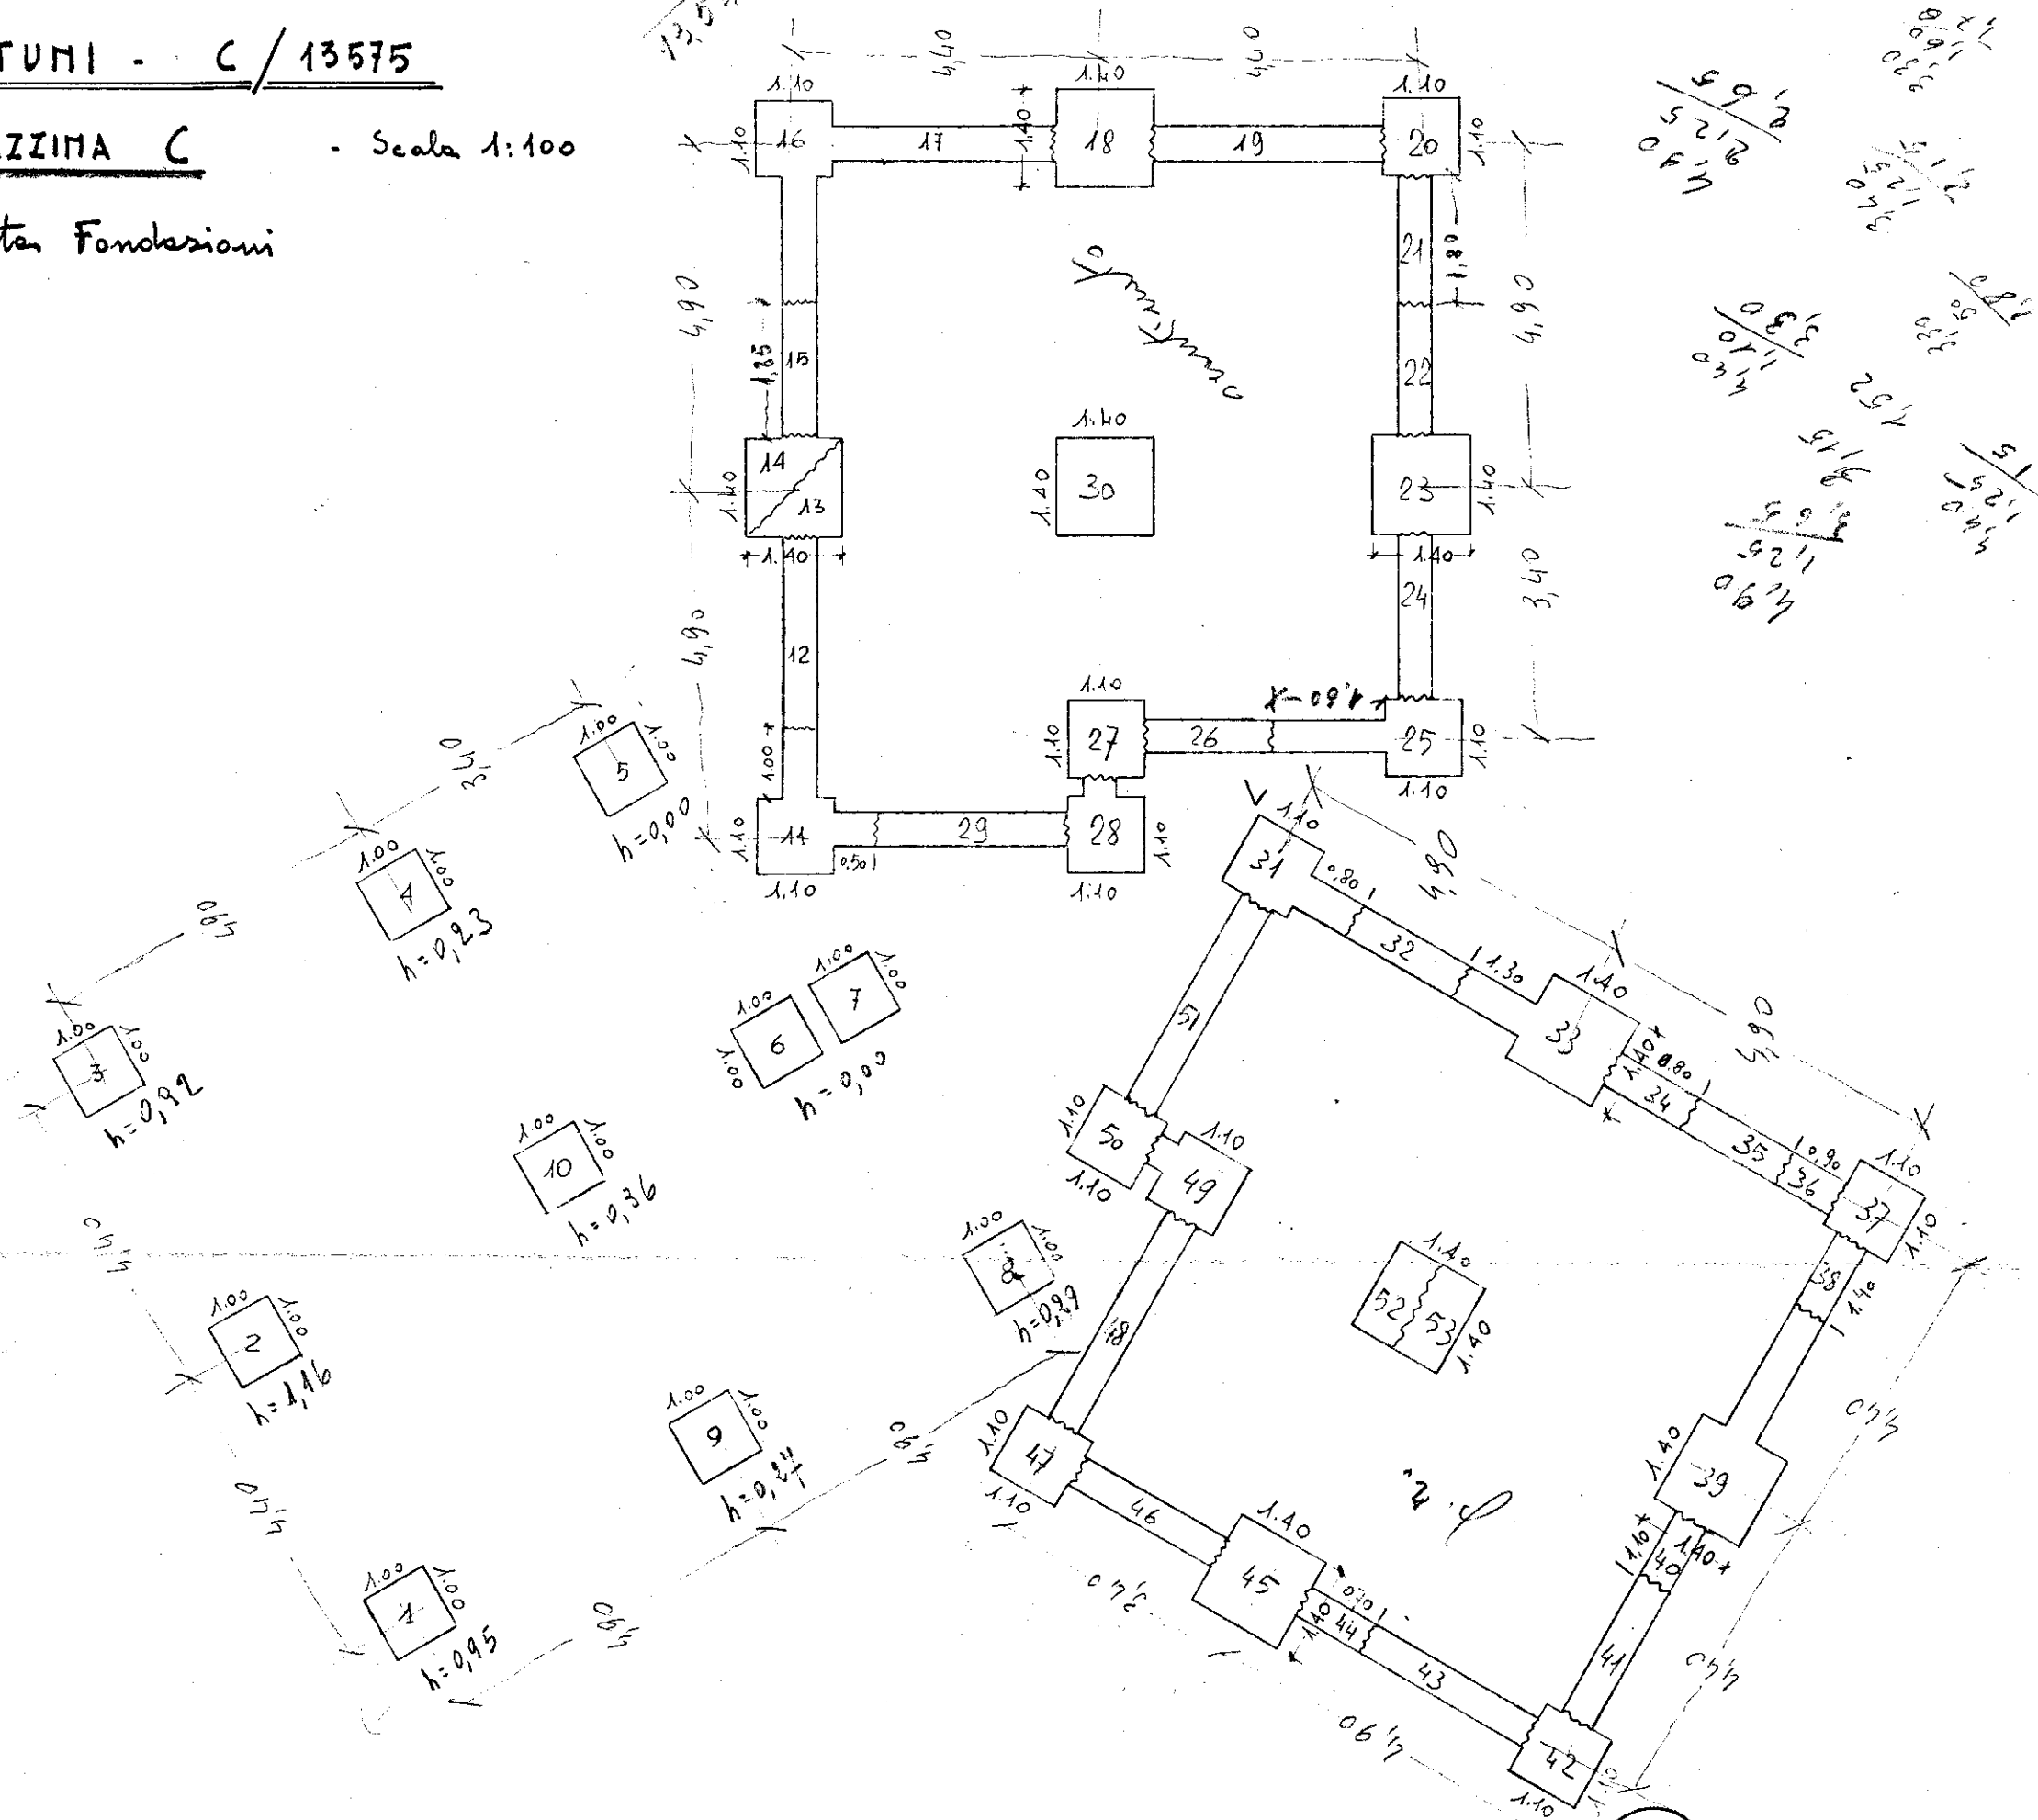

~~$h = \text{cls. for settlement:}$~~   
~~14/11/59~~ *Ch*  
 $h = 0, 10$  26/11/59