

CASE POPOLARI IN BRINDISI - 21° LOTTO - PAL. I

SCALE 1:100

PILINTA PIANO RIALZATO

Tramezz: $h = 3,08$
 Putrucci: $h = 3,03$

~~1,75~~
~~0,5~~


3,05
 1,75
 4,80
 0,50
 5,30

3,65
 2,70
 0,95

3,50
 1,20
 1,6
 0,86
 5,15
 3,15
 2,46

90
 3,85
 4,75
 3,28
 1,60
 2,68

1,02
 40
 0,62

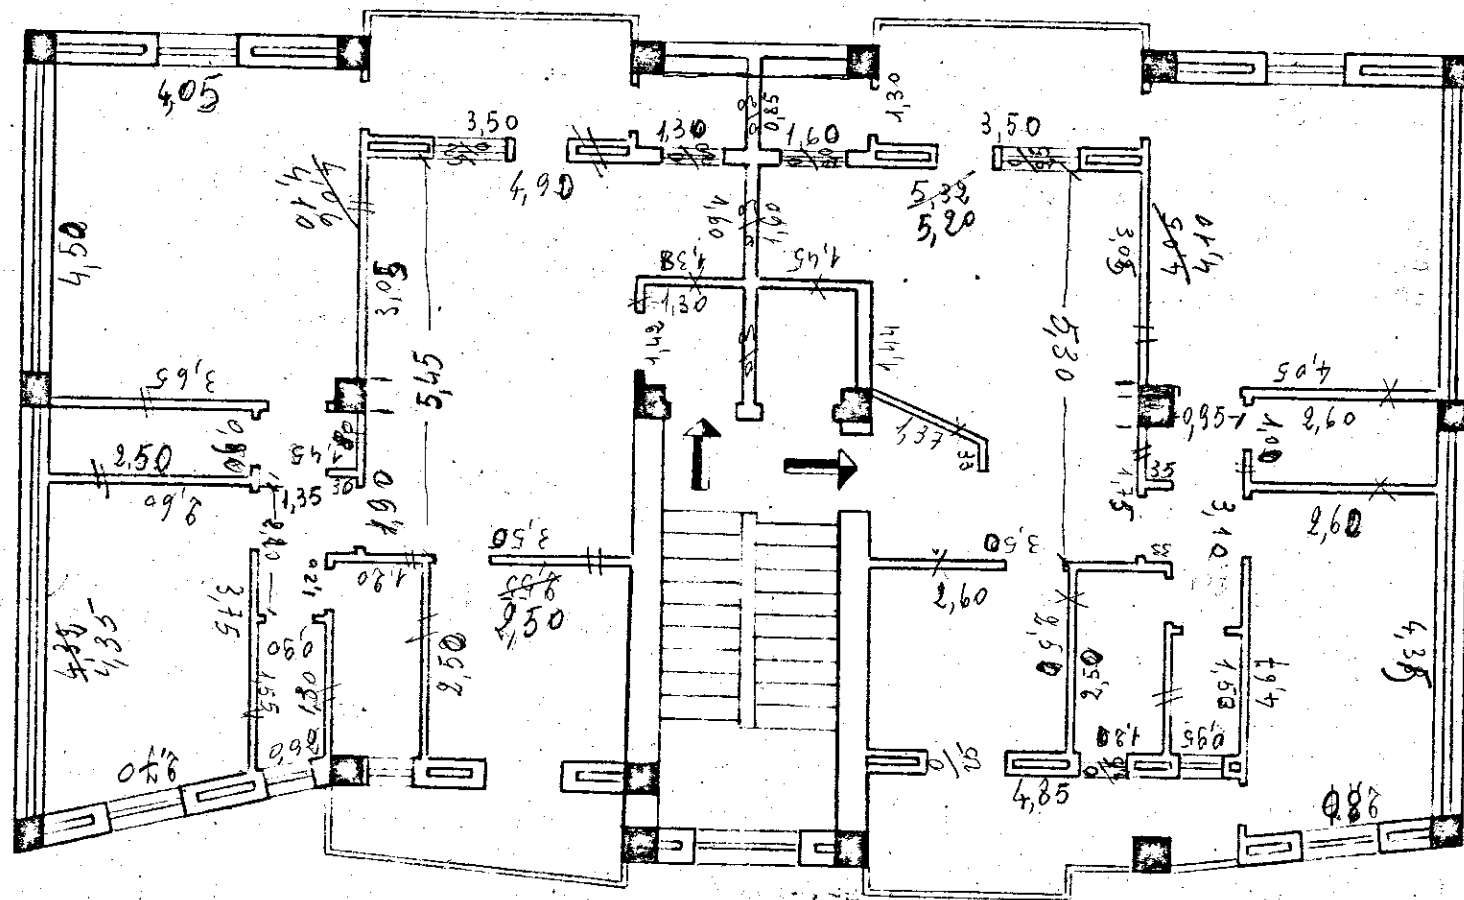

0,50
 1,30
 0,21

1,45
 2,52
 4,05

4,05
 4,05
 3,65